



www.exactalands.com | office: 773.305.4011



PROPERTY ADDRESS:
3S729 WEST AVENUE, WARRENVILLE, ILLINOIS 60555

SURVEY NUMBER: 2412.1830

DATE SIGNED: 12/20/24 **FIELD WORK DATE:** 12/17/2024

REVISION DATE(S):
(REV.1 12/20/2024)

POINTS OF INTEREST
NONE VISIBLE

STATE OF ILLINOIS } SS
COUNTY OF LASALLE }

THIS IS TO CERTIFY THAT THIS PROFESSIONAL SERVICE CONFORMS TO THE CURRENT ILLINOIS MINIMUM STANDARDS FOR A BOUNDARY SURVEY. GIVEN UNDER MY HAND AND SEAL THIS DATE HEREON.





ILLINOIS PROFESSIONAL LAND SURVEYOR No. 2971
LICENSE EXPIRES 11/30/2026
EXACTA LAND SURVEYORS, LLC
PROFESSIONAL DESIGN FIRM 184008059-0008



Exacta Land Surveyors, LLC
PDF # 184008059
o: 773.305.4011
316 East Jackson Street | Morris, IL 60450

2412.1830
PLAT OF SURVEY
DUPAGE COUNTY, ILLINOIS

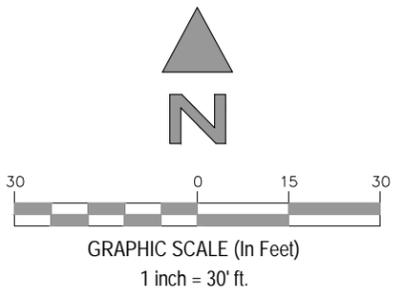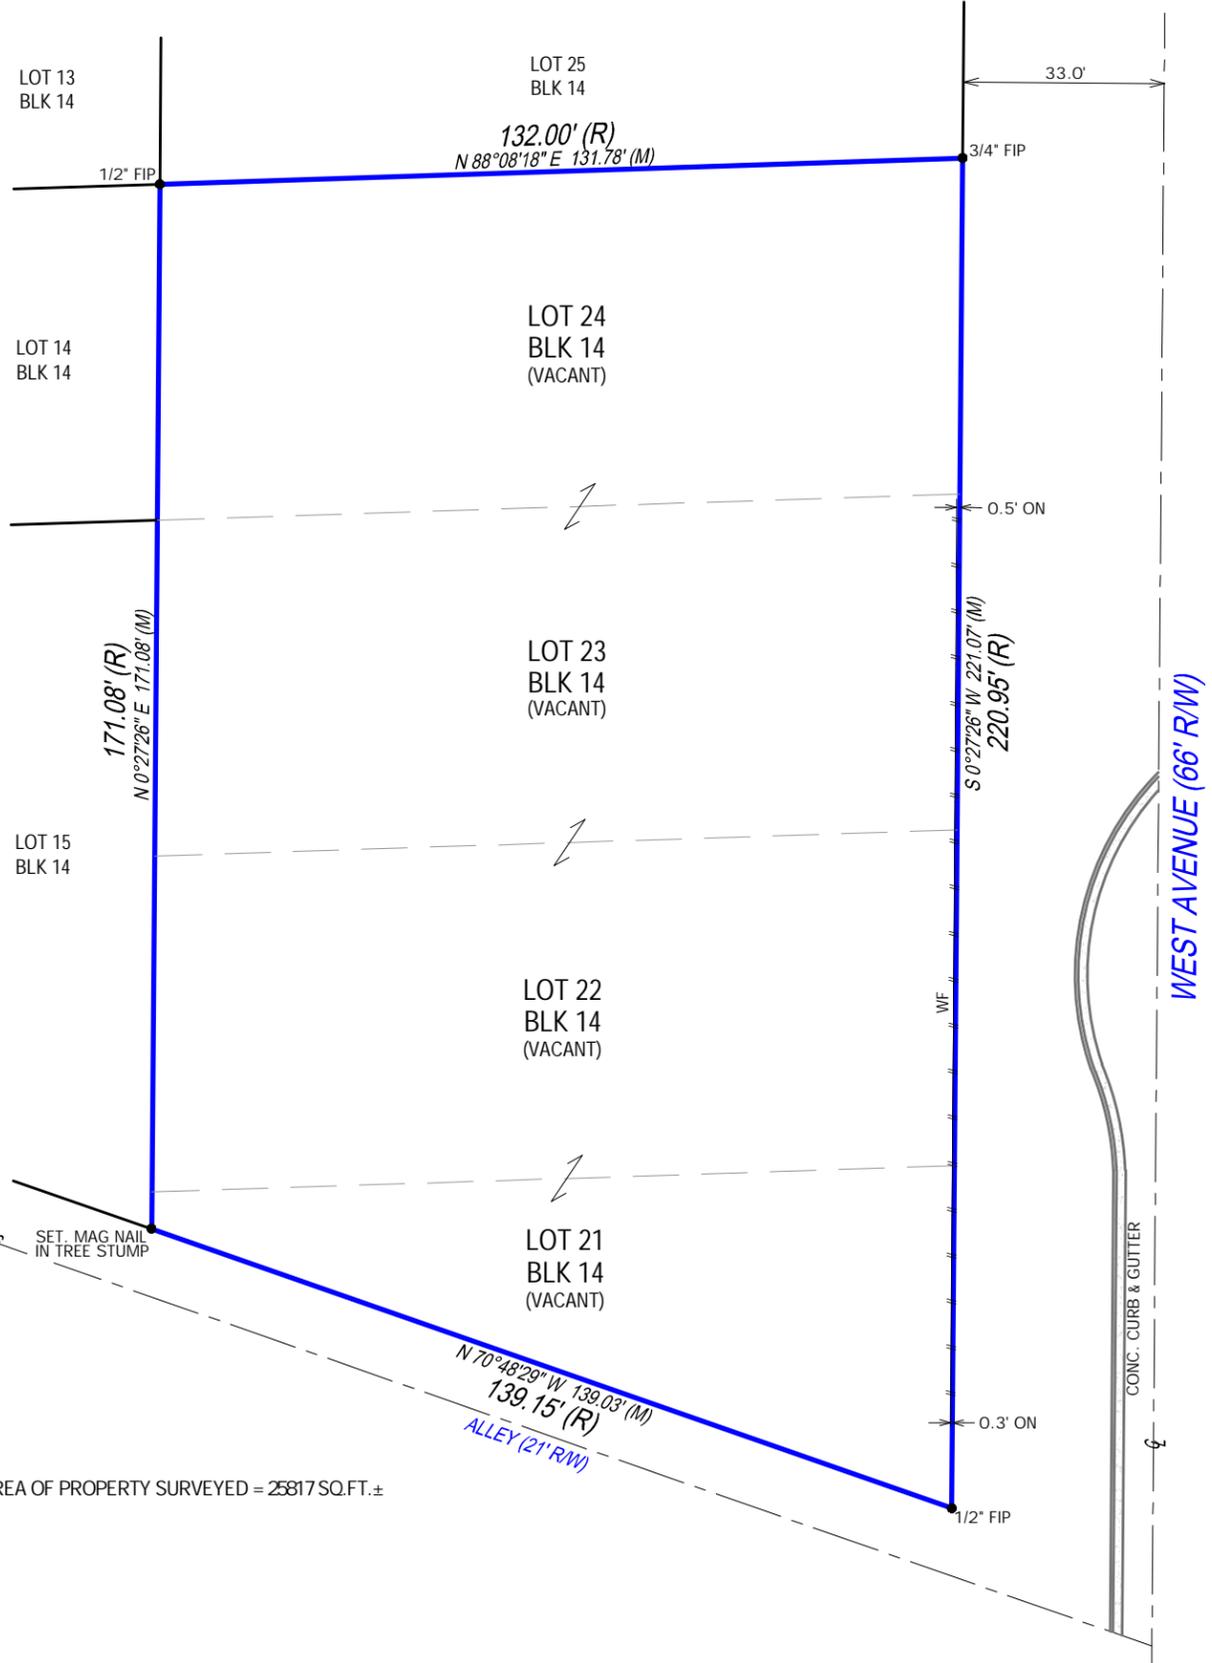

PROPERTY ADDRESS:
3S729 WEST AVENUE, WARRENVILLE, ILLINOIS 60555

SURVEY NUMBER: 2412.1830

CERTIFIED TO:
WALTER LANG; BURNET TITLE; CHICAGO TITLE INSURANCE COMPANY,;

DATE OF SURVEY: 12/20/24

BUYER: WALTER LANG

LENDER:

TITLE COMPANY: BURNET TITLE

COMMITMENT DATE: **CLIENT FILE NO:** 189225

LEGAL DESCRIPTION:
LOTS 21, 22, 23 AND 24 IN BLOCK 14 IN FIRST ADDITION TO WARRENVILLE, BEING A SUBDIVISION IN THE SOUTHEAST QUARTER OF SECTION 35 AND IN THE SOUTHWEST QUARTER OF SECTION 36, TOWNSHIP 39 NORTH, RANGE 9, EAST OF THE THIRD PRINCIPAL MERIDIAN, ACCORDING TO THE PLAT THEREOF RECORDED MARCH 8, 1927 AS DOCUMENT 231151, IN DUPAGE COUNTY, ILLINOIS.

FLOOD ZONE INFORMATION:

GENERAL SURVEYORS NOTES:

- The Legal Description used to perform this survey was supplied by others. This survey does not determine nor imply ownership of the lands or any fences shown hereon. Unless the Title Commitment Number and Date is referenced on this survey, an examination of the abstract of title was NOT performed by the signing surveyor to determine which instruments, if any, are affecting this property.
- The purpose of this survey is to establish the boundary of the lands described by the legal description provided and to depict the visible improvements thereon for a pending financial transaction. Underground footings, utilities, or other service lines, including roof eave overhangs were not located as part of this survey. Unless specifically stated otherwise the purpose and intent of this survey is not for any construction activities or future planning.
- If there is a septic tank or drain field shown on this survey, the location depicted hereon was either shown to the surveyor by a third party or it was estimated by visual above ground inspection. No excavation was performed to determine its location.
- This survey is exclusively for a pending financial transaction and only to be used by the parties to whom it is certified.
- Alterations to this survey map and report by other than the signing surveyor are prohibited.
- Dimensions are in feet and decimals thereof.
- Any FEMA flood zone data contained on this survey is for informational purposes only. Research to obtain said data was performed at www.fema.gov and may not reflect the most recent information.
- Unless otherwise noted "SIR" indicates a set iron rebar, 5/8 inch in diameter and twenty-four inches long.
- The symbols reflected in the legend and on this survey may have been enlarged or reduced for clarity. The symbols have been plotted at the approximate center of the field location and may not represent the actual shape or size of the feature.
- Points of Interest (POI's) are select above-ground improvements, which may appear in conflict with boundary, building setback or easement lines, as defined by the parameters of this survey. These POI's may not represent all items of interest to the viewer. There may be additional POI's which are not shown or called-out as POI's, or which are otherwise unknown to the surveyor.
- Utilities shown on the subject property may or may not indicate the existence of recorded or unrecorded utility easements.
- The information contained on this survey has been performed exclusively by and is the sole responsibility of Exacta Land Surveyors, LLC. Additional logos or references to third party firms are for informational purposes only.
- Due to varying construction standards, building dimensions are approximate and are not intended to be used for new construction or planning.
- Surveyor bearings are used for angular reference and are used to show angular relationships of lines only and are not related or orientated to true or magnetic north. Bearings are shown as surveyor bearings, and when shown as matching those on the subdivision plats on which this survey is based, they are to be deemed no more accurate as the determination of a north orientation made on and for those original subdivision plats. North 00 degrees East is assumed and upon preparation of this plat, the resulting bearing between found points as shown on this survey is the basis of said surveyor bearings as defined and required to be noted by Illinois Administrative Code Title 68, Chapter VII, Sub-Chapter B, Part 1270, Section 1270.56, Paragraph B, Sub-Paragraph 6, Item k.
- THIS SURVEY IS A PROFESSIONAL SERVICE IN COMPLIANCE WITH THE MINIMUM STANDARDS OF THE STATE OF ILLINOIS. NO IMPROVEMENTS SHOULD BE MADE ON THE BASIS OF THIS PLAT ALONE. PLEASE REFER ALSO TO YOUR DEED, TITLE POLICY AND LOCAL ORDINANCES. THIS DOCUMENT MAY ONLY BE USED BY THE PARTIES TO WHICH IT IS CERTIFIED.

SURVEYORS LEGEND:

LINETYPES		ABBREVIATIONS	
	Boundary Line	(C) - Calculated	FIP - Found Iron Pipe
	Center Line	(D) - Deed	FIPC - Found Iron Pipe & Cap
	Chain Link or Wire Fence	(F) - Field	FIR - Found Iron Rod
	Easement	(M) - Measured	FIRC - Found Iron Rod & Cap
	Edge of Water	(P) - Plat	FN - Found Nail
	Iron Fence	(R) - Record	FN&D - Found Nail & Disc
	Overhead Lines	(S) - Survey	FRRSPK - Found Rail Road Spike
	Structure	A/C - Air Conditioning	GAR - Garage
	Survey Tie Line	AE - Access Easement	GM - Gas Meter
	Vinyl Fence	ANE - Anchor Easement	ID - Identification
	Wall or Party Wall	ASBL - Accessory Setback Line	IE/EE - Ingress/Egress Easement
	Wood Fence	B/W - Bay/Box Window	ILL - Illegible
SURFACE TYPES		BC - Block Corner	INST - Instrument
	Asphalt	BFP - Backflow Preventer	INT - Intersection
	Brick or Tile	BLDG - Building	IRRE - Irrigation Easement
	Concrete	BLK - Block	L - Length
	Covered Area	BM - Benchmark	LAE - Limited Access Easement
	Water	BR - Bearing Reference	LB# - License No. (Business)
	Wood	BRL - Building Restriction Line	LBE - Limited Buffer Easement
SYMBOLS		BSMT - Basement	LE - Landscape Easement
	Benchmark	C - Curve	LME - Lake/Landscape Maintenance Easement
	Center Line	C/L - Center Line	LS# - License No. (Surveyor)
	Central Angle or Delta	C/P - Covered Porch	MB - Map Book
	Common Ownership	C/S - Concrete Slab	ME - Maintenance Easement
	Control Point	CATV - Cable TV Riser	MES - Mitered End Section
	Catch Basin	CB - Concrete Block	MF - Metal Fence
	Elevation	CH - Chord Bearing	MH - Manhole
	Fire Hydrant	CHIM - Chimney	MHWL - Mean High Water Line
	Find or Set Monument	CLF - Chain Link Fence	NR - Non-Radial
	Guywire or Anchor	CME - Canal Maintenance Easement	NTS - Not to Scale
	Manhole	CO - Clean Out	NAVD88 - North American Vertical Datum 1988
	Tree	CONC - Concrete	NGVD29 - National Geodetic Vertical Datum 1929
	Utility or Light Pole	COR - Corner	OG - On Ground
	Well	CS/W - Concrete Sidewalk	ORB - Official Records Book
		CUE - Control Utility Easement	ORV - Official Record Volume
		CVG - Concrete Valley Gutter	O/A - Overall
		D/W - Driveway	O/S - Offset
		DE - Drainage Easement	OFF - Outside Subject Property
		DF - Drain Field	OH - Overhang
		DH - Drill Hole	OHL - Overhead Utility Lines
		DUE - Drainage & Utility Easement	OHWL - Ordinary High Water Line
		ELEV - Elevation	ON - Inside Subject Property
		EM - Electric Meter	P/E - Pool Equipment
		ENCL - Enclosure	PB - Plat Book
		ENT - Entrance	PC - Point of Curvature
		EOP - Edge of Pavement	PCC - Point of Compound Curvature
		EOW - Edge of Water	PCP - Permanent Control Point
		ESMT - Easement	PI - Point of Intersection
		EUB - Electric Utility Box	PLS - Professional Land
		F/DH - Found Drill Hole	
		FCM - Found Concrete Monument	
		FF - Finished Floor	

JOB SPECIFIC SURVEYOR NOTES:



Exacta Land Surveyors, LLC
PDF # 184008059
o: 773.305.4011
316 East Jackson Street | Morris, IL 60450

SEE PAGE 1 OF 2 FOR MAP OF PROPERTY
PAGE 2 OF 2 - NOT VALID WITHOUT ALL PAGES